

ADDENDUM

Date August 23, 2024

To Prospective Bidders

Re Addendum No. 1 to the Construction Documents for:

State of Maine
Mackworth Island Renovations Phase 1
Falmouth, Maine
Project No. 23216

This Addendum forms a part of the Contract Documents and modifies the original Construction Documents dated July 30, 2024. Acknowledge receipt of this Addendum in the space provided in the Bid Form.

This Addendum consists of two pages, the Pre-Bid Meeting Attendance form and drawings as listed on page two.

Harriman



Mark D. Lee, AIA, LEED AP
Principal, Architect, CEO

QUESTION AND ANSWERS

Q1 What is being removed by the Owner from the buildings?

A1 Prior to mobilization, the Owner will remove the following fixtures from the building:

- **(6) Horn/Strobe units located in Room 23, Lobby, in the Main Hall.**
- **(4) Pull stations located in the Lobby, Main Hall, and the Gym.**
- **(1) Smoke detector located in the Lobby.**
- **(4) Exit signs located at doors G4, G5, G7, G8.**

Boxes of records and some remaining historical items from Building B will also be removed by the Owner prior to mobilization. All other items and fixtures to be included in the demolition scope.

Q2 What happens to the fire hydrant next to Building G during abatement and demolition?

A2 The fire hydrant adjacent to Building G shall remain. The contractor is responsible for protecting the hydrant and maintaining a clear path of access to it during abatement and demolition.

INFORMATION AVAILABLE TO BIDDERS

1. Pre-bid meeting attendance form is issued with this addendum.

CHANGES TO SPECIFICATIONS

1. SECTION 002000 – INFORMATION AVAILABLE TO BIDDERS

- a. Article 1.1, A., 6., delete in its entirety.
- b. Existing Conditions Document attachment, delete SW Cole Geotech 24-0493 Report, pages 161 through 188.

2. SECTION 045000 – MASONRY

- a. Article 1.6, D., delete and replace with the following:
“D. Submit a full range of brick masonry units and mortar samples to match the existing color, size, and texture. Note that there shall be an unlimited number of samples provided for brick-and-mortar for selection by the Architect.”
- b. Article 1.6, add the following:
“G. Submit colors and texture for precast concrete chimney cap. Note that there shall be an unlimited number of samples provided for selection by the Architect.”
- c. Article 1.7, A., 1., delete and replace with the following:
“1. Four (4) square foot of mortar repointing. Note for brick-and-mortar selection, there shall be an unlimited amount of sample test areas until final mortar selection is made.”

DRAWINGS REVISED AND REISSUED WITH THIS ADDENDUM, DATED 08-23-2024:

1. DRAWING C00-1 - SITE NOTES
2. DRAWING C10-1 - EXISTING SITE CONDITIONS AND DEMOLITION PLAN
3. DRAWING C10-2 - EXISTING SITE CONDITIONS AND DEMOLITION PLAN
4. DRAWING C20-1 - SITE LAYOUT
5. DRAWING C30-1 - SITE GRADING AND EROSION CONTROL PLAN
6. DRAWING A01-1 - INDEX PLAN
7. DRAWING A05-1G - DEMOLITION PLAN – BUILDING G

PRE-BID MEETING ATTENDANCE FORM

Please print legibly

Project Name: State of Maine, Mackworth Island, Renovations Phase 1 (BGS #3675)

Project No.: 23216

	NAME	COMPANY	BUSINESS PHONE	E-MAIL
1.	Joe Gammon	Joe Gammon and Sons	207-956-3720	joegammonandsons@gmail.com
2.	Josh White	Gendron & Gendron	207-782-7372	josh@gendroncorp.com
3.	Tyler Coffin	Doten's Construction	207-233-9005	tyler@dotens.com
4.	Matt Dalt	CCB	207-887-3230	mdalt@ccb-inc.com
5.	Brendan Whalen	RJ Grondin	207-854-1147	estimators@rjgrodin.com
6.	Kevin Freeman	Landry/French	207-650-8649	kfreeman@landryfrench.com
7.	Anthony Mancini	Mancini Electric	207-774-5829	gmancini@mancinielectric.com
8.	Annette Bourque	Neokraft Signs	207-705-4088	annette@neokraft.com
9.	Matt Rague	Benchmark	207-671-3422	krice@benchmarkconstruction.com
10.	Deirdre Wadsworth	Hardypond Construction	207-450-2212	deidre@hardypond.com
11.	Alex Hatch	EJ Perry Construction	207-691-1846	ahatch@ejperry.com
12.	Trevor Lawrence	Lakeside CC & AP	207-712-5365	tlawrence@lakesideap.com
13.	John Weeks	Nelson Property Services	207-650-3483	jweeks@npsmaine.com
14.	Peter Jabbusch	Atlantic Environmental	207-740-6743	pjabbusch@gecne.net
15.				
16.				
17.				
18.				

1. THE LANDSCAPE CONTRACTOR SHALL SUPPLY AND INSTALL ALL PLANTS IN SUFFICIENT QUANTITIES TO COMPLETE WORK AS SHOWN ON THE DRAWINGS. DISCREPANCIES BETWEEN QUANTITIES SHOWN ON THE DRAWING AND THE PLANT LIST SHALL BE REPORTED IMMEDIATELY TO THE ARCHITECT AND SHALL NOT ENTITLE THE CONTRACTOR TO ADDITIONAL COMPENSATION.

2. THE LANDSCAPE CONTRACTOR IS ADVISED THAT BOTH ABOVE AND BELOW GROUND UTILITIES EXIST ON THE SITE, THE LOCATIONS OF WHICH SHALL BE VERIFIED BY THE CONTRACTOR PRIOR TO COMMENCEMENT OF HIS OPERATIONS. SHOULD THE LOCATION OF ANY PROPOSED PLANTING CONFLICT WITH ANY UTILITY, THE ARCHITECT SHALL BE NOTIFIED IMMEDIATELY FOR DECISION.

3. PAVING, CURBING, UTILITIES, GRASS, ETC., DAMAGED AS A RESULT OF THE LANDSCAPE CONTRACTOR'S OPERATIONS SHALL BE REPAIRED OR REPLACED AT NO ADDITIONAL COST TO THE OWNER.

4. AREAS RECEIVING PLANTINGS INCLUDING TREE PITS, AND SHRUB AND GROUND COVER BEDS, SHALL BE MULCHED TO A DEPTH OF 4" MINIMUM WITH AN APPROVED CLEAN, UNIFORMLY GROUND OR SHREDDED PINE OR HEMLOCK BARK MULCH. SAMPLE OF BARK MULCH TO BE USED SHALL BE SUBMITTED TO THE ARCHITECT FOR APPROVAL PRIOR TO SITE DELIVERY.

5. FLOWER BEDS SHALL RECEIVE NO LESS THAN 12" OF TOPSOIL.

6. THE LANDSCAPE CONTRACTOR SHALL RELOCATE PLANTS ACCORDING TO THE DIRECTION OF THE ARCHITECT.

7. PLANT MATERIALS CALLED FOR AND INSTALLED SHALL MEET OR EXCEED THE SPECIFICATIONS OF THE AMERICAN STANDARDS FOR NURSERY STOCK (LATEST EDITION) AS SET FORTH BY THE AMERICAN ASSOCIATION OF NURSERYMEN.

8. BEDS SHALL BE NEATLY EDGED AND DEFINED. FINAL PLANTING BED LAYOUT AND LOCATIONS SHALL BE FIELD COORDINATED AND APPROVED BY ARCHITECT PRIOR TO INSTALLATION.

9. IF SUBSTITUTIONS ARE NECESSARY, CONTRACTOR SHALL NOTIFY ARCHITECT OF PROPOSED REPLACEMENT PLANT(S). SUBSTITUTIONS SHALL BE OF SIMILAR BOTANICAL CHARACTERISTICS.

10. TREES NORMALLY DO NOT NEED TO BE STAKED AND STAKING CAN BE HARMFUL TO THE TREE. STAKING SHOULD BE DONE ONLY WITH THE APPROVAL OF THE ARCHITECT IF IT IS EXPECTED THAT THE TREE WILL NOT BE ABLE TO SUPPORT ITSELF. THE FOLLOWING ARE REASONS WHY TREES DO NOT REMAIN STRAIGHT:

- TREES WITH POOR - QUALITY ROOT BALLS OR ROOT BALLS THAT HAVE BEEN CRACKED OR DAMAGED. REJECT RATHER THAN STAKE.
- TREES THAT HAVE GROWN TOO CLOSE TOGETHER IN THE NURSERY, RESULTING IN WEAK TRUNKS. REJECT RATHER THAN STAKE.
- PLANTING PROCEDURES THAT DO NOT ADEQUATELY TAMP SOILS AROUND THE ROOT BALL. CORRECT THE PLANTING PROCEDURE.
- ROOT BALLS PLACED ON SOFT SOIL. TAMP SOILS UNDER ROOT BALL PRIOR TO PLANTING.
- ROOT BALLS WITH VERY SANDY SOIL OR VERY WET CLAY SOIL. STAKING ADVISABLE.
- TREES LOCATED IN A PLACE OF EXTREMELY WINDY CONDITIONS. STAKING ADVISABLE.
- TREES LOCATED IN PARKING LOT ISLANDS. STAKING ADVISABLE.

1. THE ACCURACY AND COMPLETENESS OF SUBSURFACE INFORMATION IS NOT GUARANTEED. VERIFY SITE CONDITIONS INCLUDING TEST PITS FOR LOCATIONS AND INVERTS OF UTILITIES AND REPORT ANY DISCREPANCIES TO ARCHITECT PRIOR TO PROCEEDING WITH THAT PORTION OF THE WORK.

2. CLEAN SEDIMENT FROM NEW STORM DRAINS AND CATCH BASINS, AND ALSO FROM EXISTING STORM DRAINS AND CATCH BASINS THAT DIRECTLY RECEIVE RUNOFF FROM THE WORK AREA.

3. COORDINATE WORK ON UTILITY LINES OR WITHIN ROAD RIGHT-OF-WAY WITH THE UTILITY COMPANIES AND CITY/TOWN ROAD DEPARTMENT AND STATE MDOT AND WITH OWNER.

4. SLOPE CONDUITS AWAY FROM BUILDING TO HANDHOLE OR UTILITY POLE TO AVOID GROUND WATER SEEPAGE INTO BUILDING.

5. RESET RIMS OF EXISTING UTILITY STRUCTURES, MANHOLES & CATCH BASINS TO NEW GRADE.

6. PRIOR TO REMOVAL OF UTILITIES, VERIFY UTILITY FUNCTION, MATERIAL, USE, AND CURRENT ACTIVITY. REPORT DISCREPANCIES TO THE ARCHITECT FOR DIRECTION PRIOR TO COMMENCING THE WORK ON THAT UTILITY.

C1 LANDSCAPING NOTES

SCALE: N.T.S.

C3 UTILITY NOTES

SCALE: N.T.S.

EXISTING	PROPOSED

PRIOR TO EXCAVATION, VERIFY THE UNDERGROUND UTILITIES, PIPES, STRUCTURES, AND FACILITIES. PROVIDE THE FOLLOWING MINIMUM MEASURES:

A. PRE-MARK THE BOUNDARIES OF YOUR PLANNED EXCAVATION WITH WHITE PAINT, FLAGS OR STAKES, SO UTILITY CREWS KNOW WHERE TO MARK THEIR LINES.

B. CALL DIG SAFE, AT EITHER 811 OR 1-888-DIGSAFE, AT LEAST 72 BUSINESS HOURS - BUT NO MORE THAN 30 CALENDAR DAYS - BEFORE STARTING WORK. DON'T ASSUME SOMEONE ELSE WILL MAKE THE CALL.

C. IF BLASTING, NOTIFY DIG SAFE AT LEAST 24 BUSINESS HOURS IN ADVANCE.

D. WAIT 72 HOURS FOR LINES TO BE LOCATED AND MARKED WITH COLOR-CODED PAINT, FLAGS OR STAKES. NOTE THE COLOR OF THE MARKS AND THE TYPE OF UTILITIES THEY INDICATE. TRANSFER THESE MARKS TO THE AS-BUILT DRAWINGS.

E. CONTACT THE LANDOWNER AND OTHER "NON-MEMBER" UTILITIES (WATER, SEWER, GAS, ETC.), FOR THEM TO MARK THE LOCATIONS OF THEIR UNDERGROUND FACILITIES. TRANSFER THESE MARKS TO THE AS-BUILT DRAWINGS.

F. RE-NOTIFY DIG SAFE AND THE NON-MEMBER UTILITIES IF THE DIGGING, DRILLING OR BLASTING DOES NOT OCCUR WITHIN 30 CALENDAR DAYS, OR IF THE MARKS ARE LOST DUE TO WEATHER CONDITIONS, SITE WORK ACTIVITY OR ANY OTHER REASON.

G. HAND DIG WITHIN 18 INCHES IN ANY DIRECTION OF ANY UNDERGROUND LINE UNTIL THE LINE IS EXPOSED. MECHANICAL METHODS MAY BE USED FOR INITIAL SITE PENETRATION, SUCH AS REMOVAL OF PAVEMENT OR ROCK.

H. DIG SAFE REQUIREMENTS ARE IN ADDITION TO TOWN, CITY AND/OR STATE DOT STREET OPENING PERMIT REQUIREMENTS.

I. FOR COMPLETE DIG SAFE REQUIREMENTS, VISIT THEIR WEBSITE.

J. IF YOU DAMAGE, DISLOCATE OR DISTURB ANY UNDERGROUND UTILITY LINE, IMMEDIATELY NOTIFY THE AFFECTED UTILITY. IF DAMAGE CREATES SAFETY CONCERNS, CALL THE FIRE DEPARTMENT AND TAKE IMMEDIATE STEPS TO SAFEGUARD HEALTH AND PROPERTY.

K. ANY TIME AN UNDERGROUND LINE IS DAMAGED OR DISTURBED, OR IF LINES ARE IMPROPERLY MARKED, YOU MUST CALL DIGSAFE.

B2 DIG SAFE NOTES

SCALE: N.T.S.

B3 GRADING NOTES

SCALE: N.T.S.

B4 GENERAL SITE NOTES

SCALE: N.T.S.

CURB ABBREVIATIONS	
RVGC	RE-SET VERTICAL GRANITE CURB
VGC	NEW VERTICAL GRANITE CURB
SGC	NEW SLOPED GRANITE CURB
FGC	NEW GRANITE CURB FLUSH WITH PAVEMENT
TCE	NEW TAPERED GRANITE CURB ENDS (TIP DOWNS)
TRC	NEW TRANSITIONAL CURB
BC	NEW BITUMINOUS CURB
CCBC	NEW CAPE COD BITUMINOUS CURB
PCC	NEW PRE-CAST CONCRETE CURB
CCC	NEW CAST-IN-PLACE CONCRETE CURB

PAINT STRIPING ABBREVIATIONS	
SWSL	SINGLE WHITE SOLID LINE
SWDL	SINGLE WHITE DASHED LINE
YSL	SINGLE YELLOW SOLID LINE
SYDL	SINGLE YELLOW DASHED LINE
DYSL	DOUBLED YELLOW SOLID LINE

GENERAL ABBREVIATIONS	
BIT.	BITUMINOUS
C.O.	CLEAN-OUT
CONC.	CONCRETE
DI.	DRAIN INLET
ELEV.	ELEVATION
EXG.	EXISTING
F.F.E.	FINISHED FLOOR ELEVATION
FT	FEET
GW	GEOTHERMAL WELL
IN.	INCHES
INV.	INVERT
MAX.	MAXIMUM
MIN.	MINIMUM
N.I.C.	NOT IN CONTRACT
NCB	NEW CATCH BASIN
NFO	NEW FIBER OPTIC
NGW	NEW GEOTHERMAL WATER
NLP	NEW LIGHT POLE
NSD	NEW SEWER
NSFM	NEW SEWER FORCE MAIN
NSL	NEW SPOT LIGHT
NUD	NEW UNDERDRAIN
NUJ	NEW UNDERGROUND ELECTRICAL
NUG	NEW UNDERGROUND GAS
NUF	NEW UNDERGROUND FUEL
NUSC	NEW UNDERGROUND SPARE CONDUIT
NW	NEW WATER
NWF	NEW WALL FIXTURE
P.C.	PRECAST
R	RAMP
S	STRUCTURAL PAD
SQ	SQUARE
T	TRANSITIONAL PAD
TBM	TEMPORARY BENCH MARK
TYP	TYPICAL
W	WITH
UNO	UNLESS NOTED OTHERWISE

A1 STANDARD SITE LEGEND

SCALE: N.T.S.

A2 STANDARD SITE ABBREVIATIONS

SCALE: N.T.S.

A4 SIGN LEGEND

SCALE: N.T.S.

A5 SURVEYOR NOTES

SCALE: N.T.S.

1. PROVIDE 4" LOAM, SEED AND MULCH TO DISTURBED AREAS UNLESS OTHERWISE NOTED. PROVIDE EROSION CONTROL MESH ON ALL SLOPES 6:1 OR STEEPER, AND ALONG DITCH CHANNELS.

2. GRADE SURFACES TO DRAIN AWAY FROM BUILDING. PUDDLING OF WATER IN PAVED OR UNPAVED AREAS WILL NOT BE ACCEPTABLE EXCEPT FOR AREAS DESIGNATED AS PONDS.

3. MAINTAIN TEMPORARY EROSION CONTROL MEASURES FOR THE FULL DURATION OF CONSTRUCTION. INSPECT WEEKLY AND AFTER EACH STORM AND REPAIR AS NEEDED. REMOVE SEDIMENTS FROM THE SITE. PLACE IN AREA OF LOW EROSION POTENTIAL, AND STABILIZE WITH SEED AND MULCH.

4. PLACE TEMPORARY SOIL STABILIZATION WITHIN 30 DAYS OF INITIAL DISTURBANCE. PLACE PERMANENT SOIL STABILIZATION WITHIN 7 DAYS OF FINAL GRADING.

1. RELOCATE EXISTING TBM INFORMATION ONTO NEW TBM OF CONTRACTORS CHOICE FOR CONSTRUCTION USE PRIOR TO REMOVAL OF EXISTING TBM.

2. IF EXISTING ASBESTOS CEMENT PIPE IS ENCOUNTERED, HANDLE AND DISPOSE OF ASBESTOS MATERIALS WITH CARE AND IN ACCORDANCE WITH APPLICABLE CODES AND SAFETY STANDARDS.

3. EXCAVATE AND STOCKPILE ON-SITE TOPSOIL. TOPSOIL IS TO REMAIN THE PROPERTY OF THE OWNER DURING CONSTRUCTION. AFTER FINAL LOAM AND SEED EXCESS TOPSOIL SHALL BE REMOVED FROM SITE BY CONTRACTOR.

4. DIMENSIONS ARE TO FACE OF CURB AND TO FACE OF FOUNDATION UNLESS OTHERWISE INDICATED.

5. PAVEMENT EDGES SHALL BE TRUE TO LINE. SAWCUT EXISTING PAVEMENT IN SMOOTH STRAIGHT LINE WHERE NEW PAVEMENT JOINS. PROVIDE TACK COAT LAYER AS SPECIFIED.


6. CONTRACTOR SHALL VERIFY SITE CONDITIONS, INCLUDING TEST PITS FOR LOCATIONS AND INVERTS OF UTILITIES, AND REPORT ANY DISCREPANCIES TO ARCHITECT PRIOR TO PROCEEDING WITH THAT PORTION OF THE WORK.

7. PROVIDE TRAFFIC CONTROL SIGNAGE AND STRIPING AS SHOWN AND IN ACCORDANCE WITH U.S.D.O.T. MANUAL ON UNIFORM TRAFFIC CONTROL DEVICES.

8. CONTRACTOR IS RESPONSIBLE FOR PROTECTION OF EXISTING TREES TO REMAIN.

9. CONTRACTOR IS RESPONSIBLE FOR REMOVAL OF TREES THAT ARE DAMAGED BEYOND RECOVERY, KILLED OR NEED TO BE REMOVED FOR DEMOLITION ACCESS.

(See measure 1 when plotted at full size)

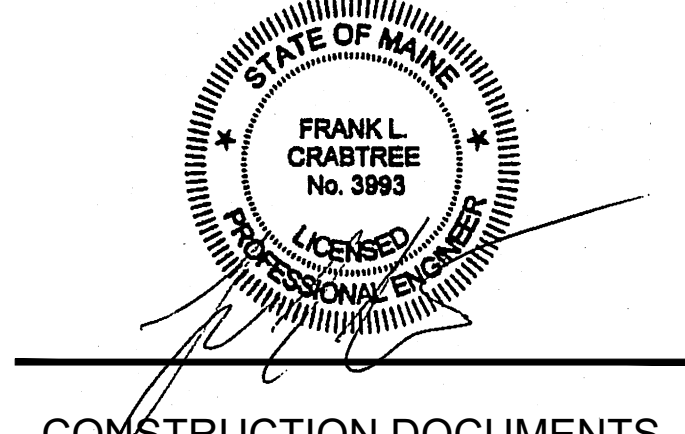

CONSTRUCTION DOCUMENTS

JULY 30, 2024




Revision Date	Revision Description
08-23-2024	ADDENDUM 1

Revision Date: 08-23-2024
Revision Description: ADDENDUM 1

Drawn by: FLC / TNE

SITE NOTES

C00-1

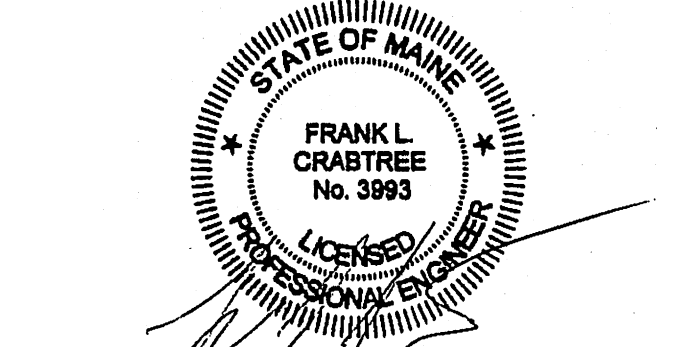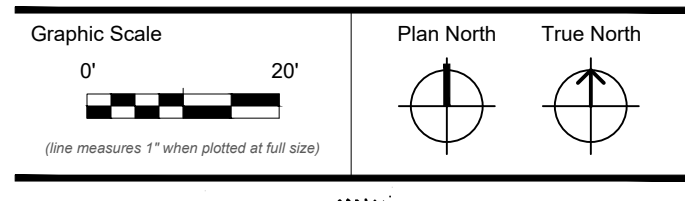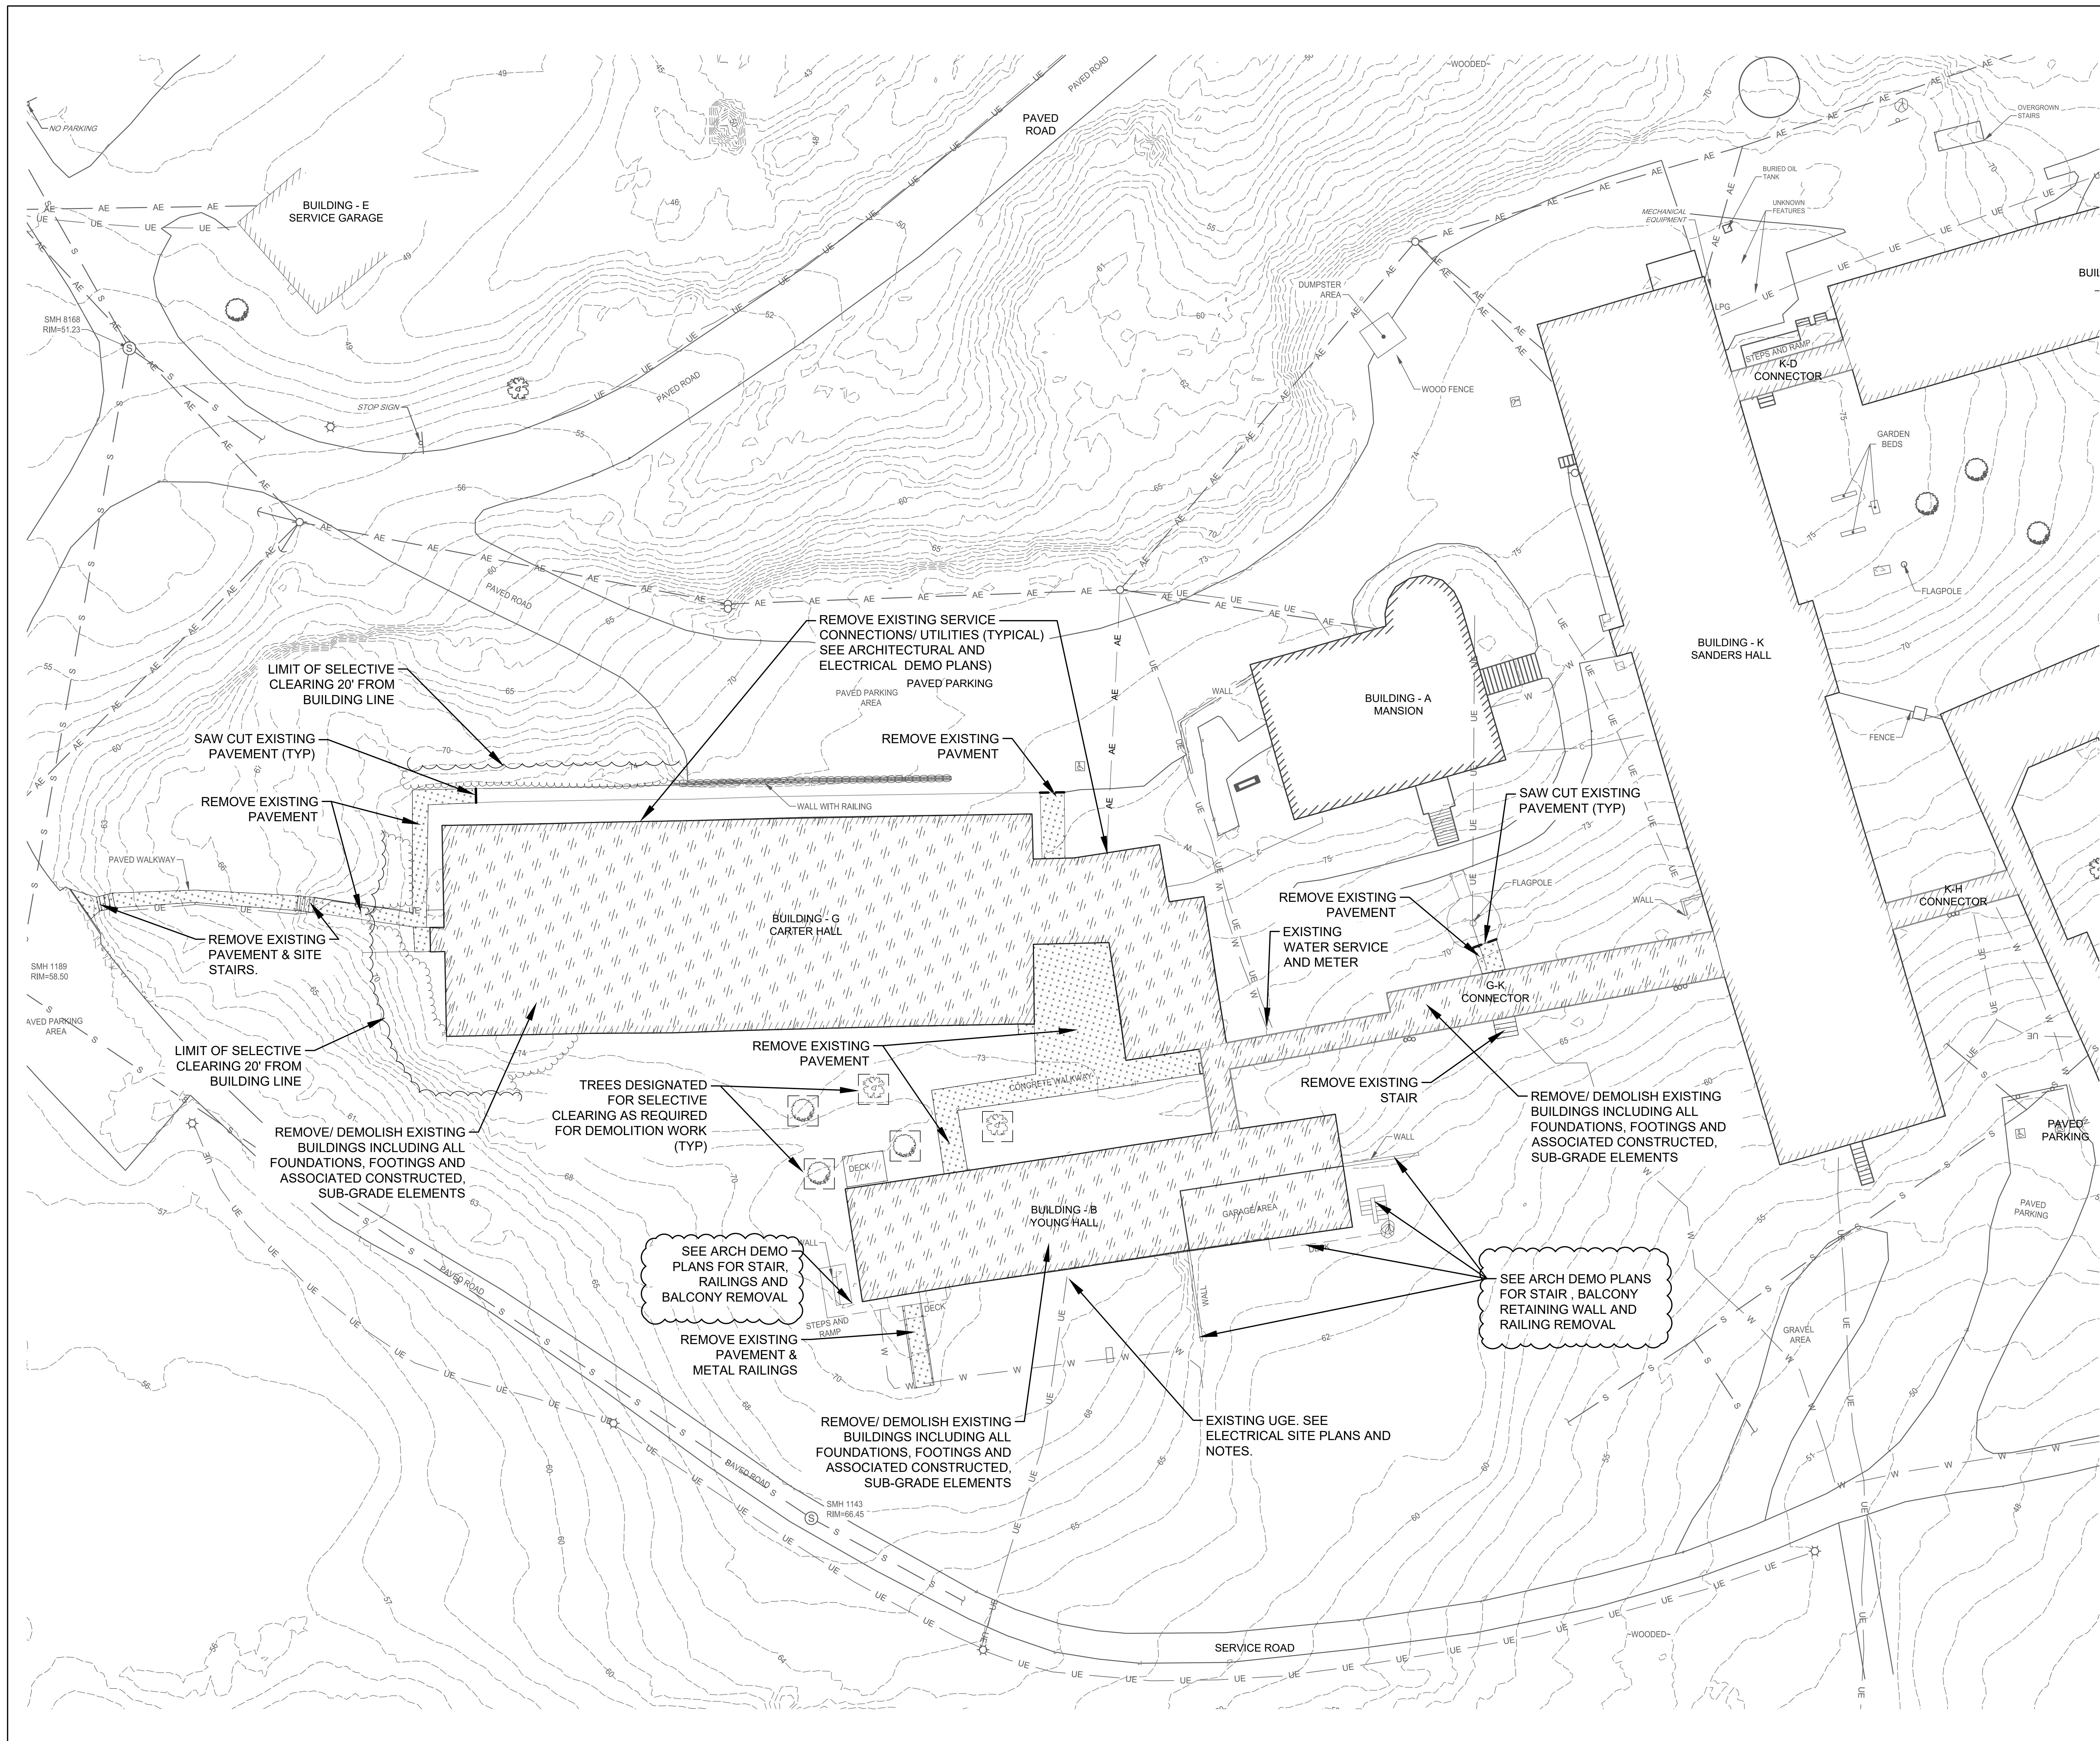




CONSTRUCTION DOCUMENTS

JULY 30, 2024

Revision Date: 08-23-2024
Revision Description: ADDENDUM 1

Drawn by: FLC / TNE

EXISTING SITE
CONDITIONS AND
DEMOLITION PLAN

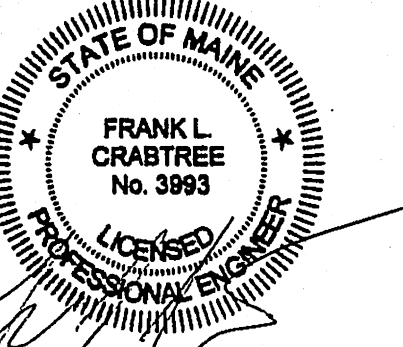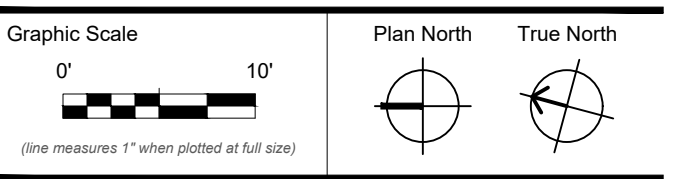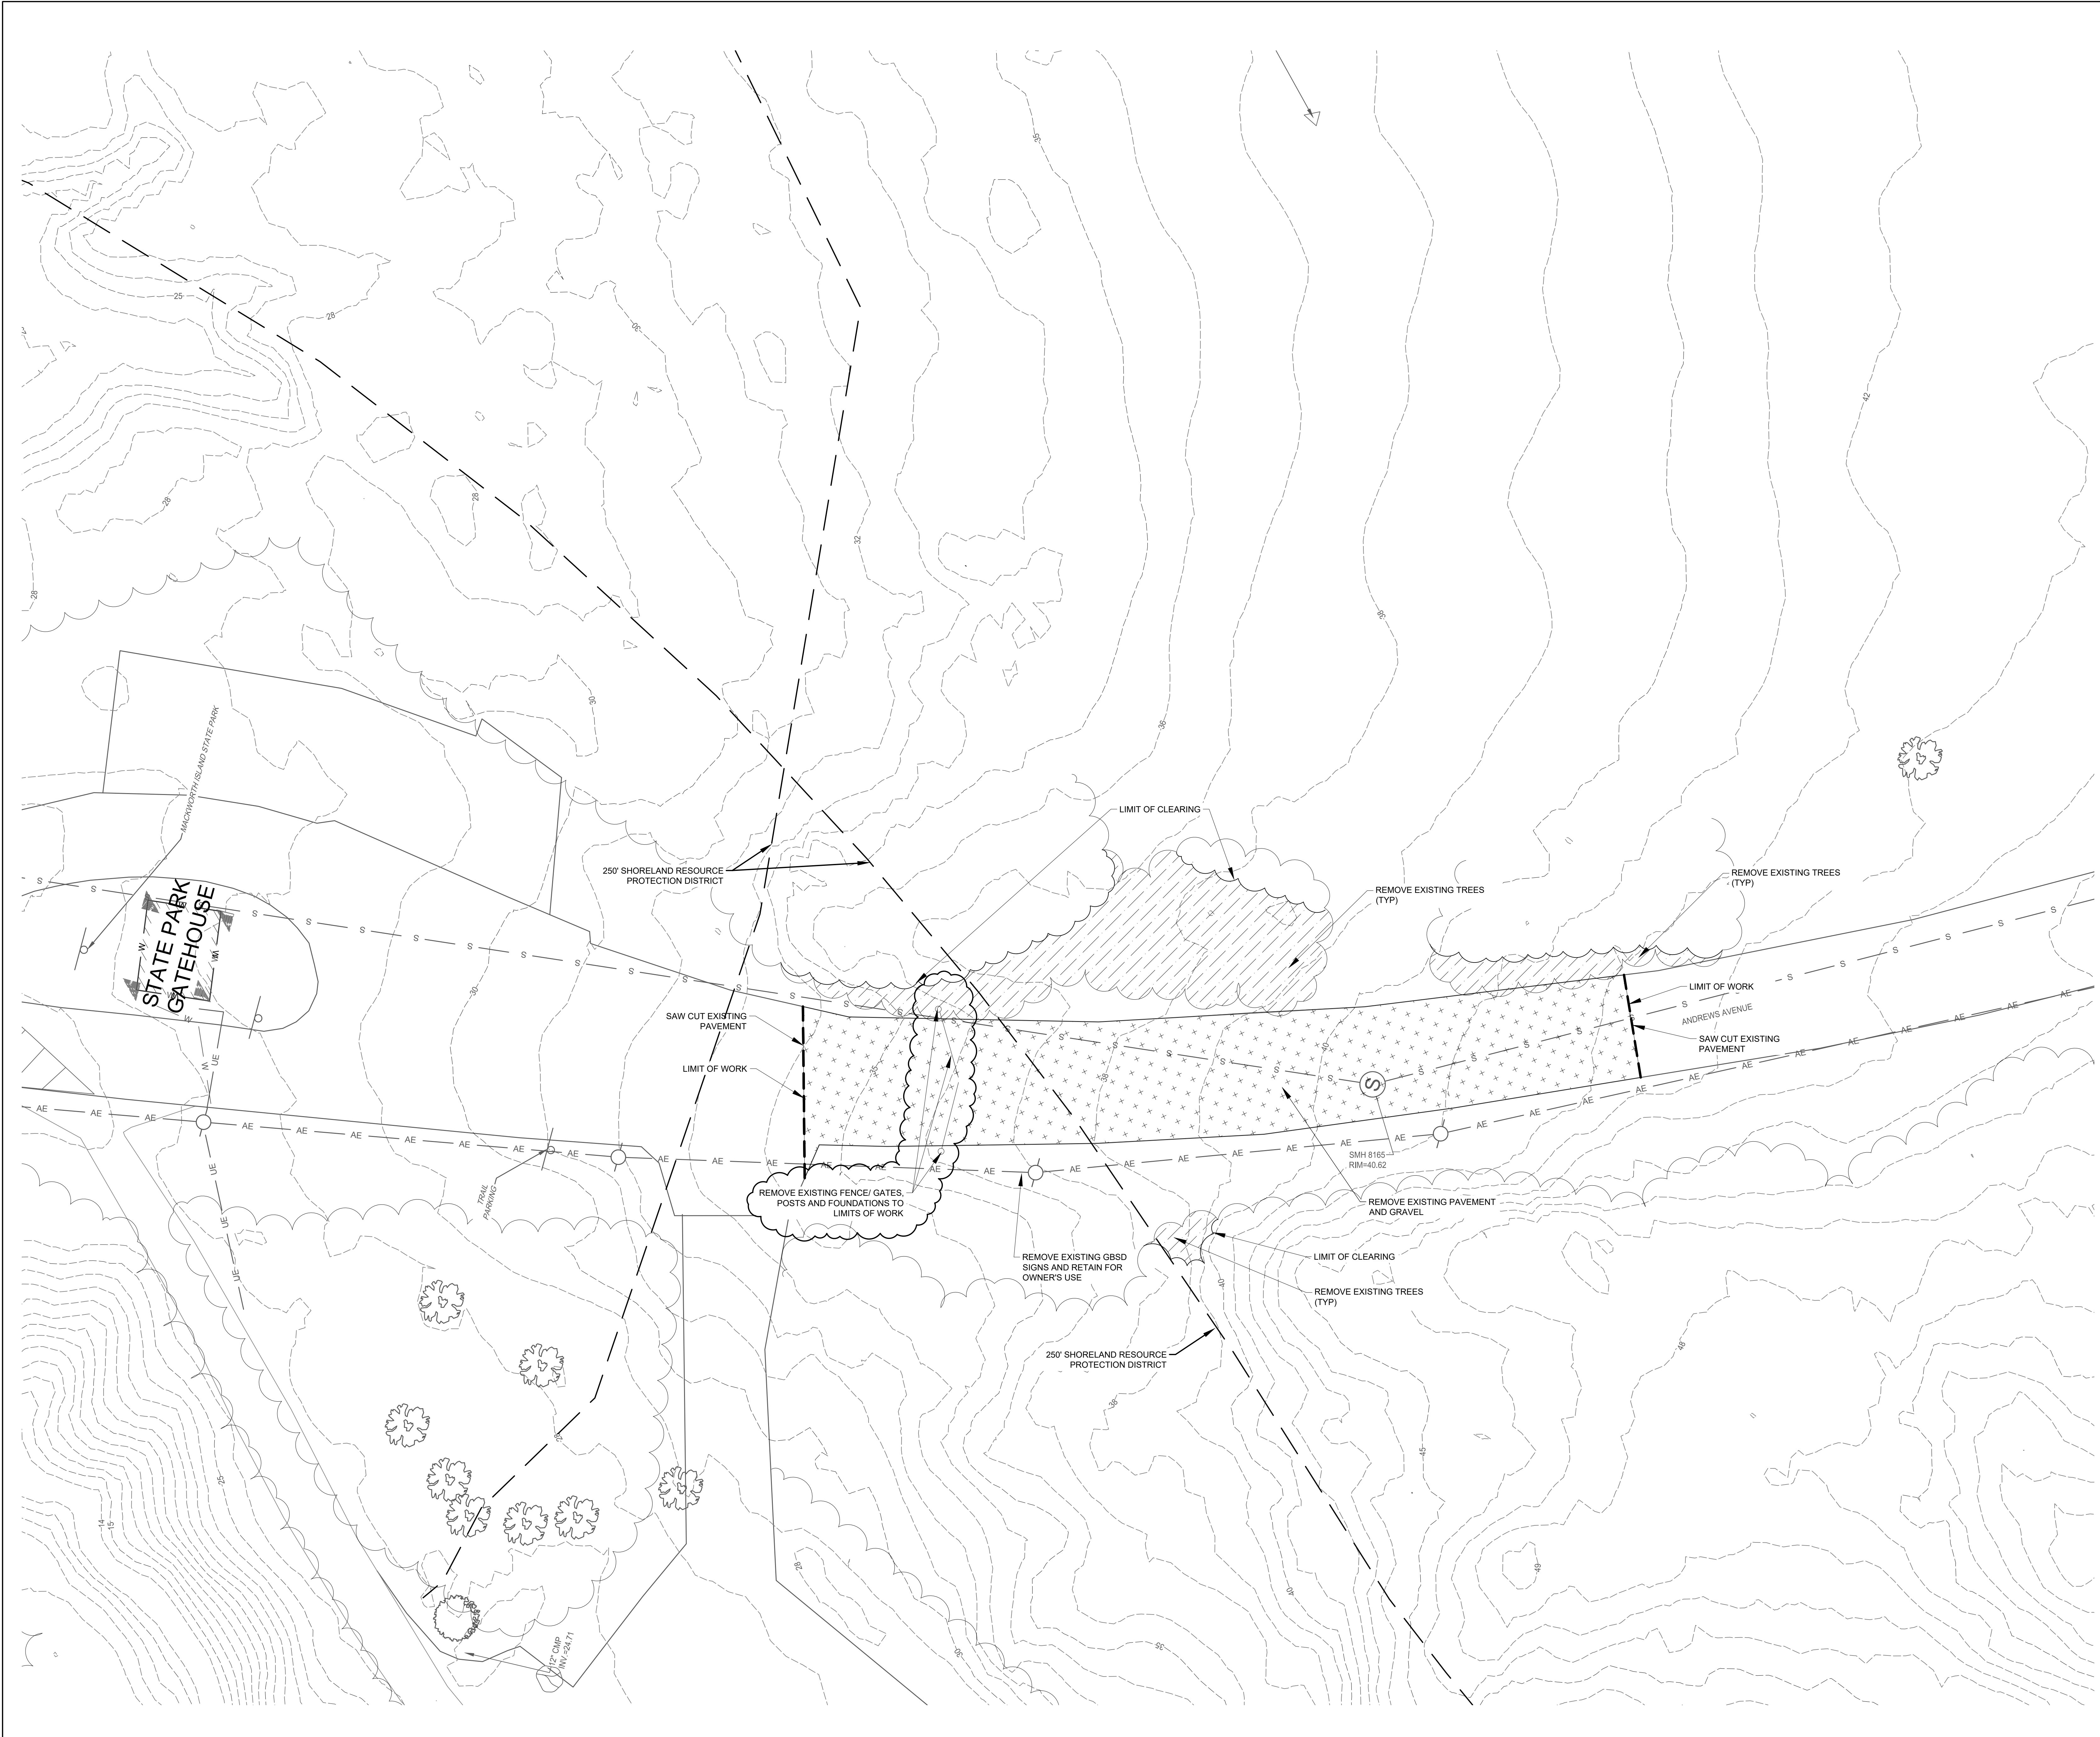




CONSTRUCTION DOCUMENTS

JULY 30, 2024

Revision Date	Revision Description
08-23-2024	ADDENDUM 1

Drawn by: FLC / TNE

EXISTING SITE
CONDITIONS AND
DEMOLITION PLAN

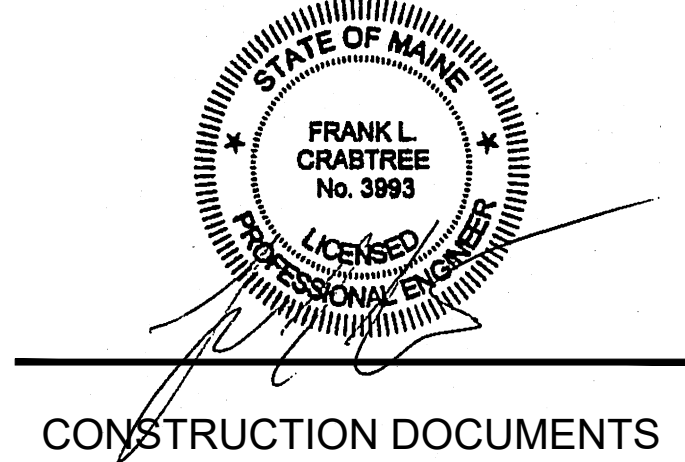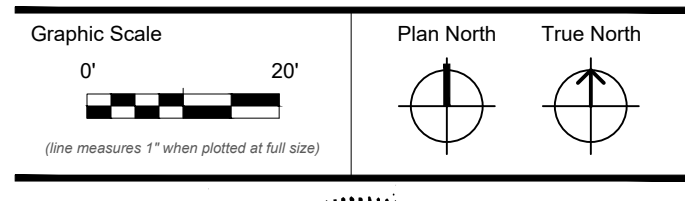
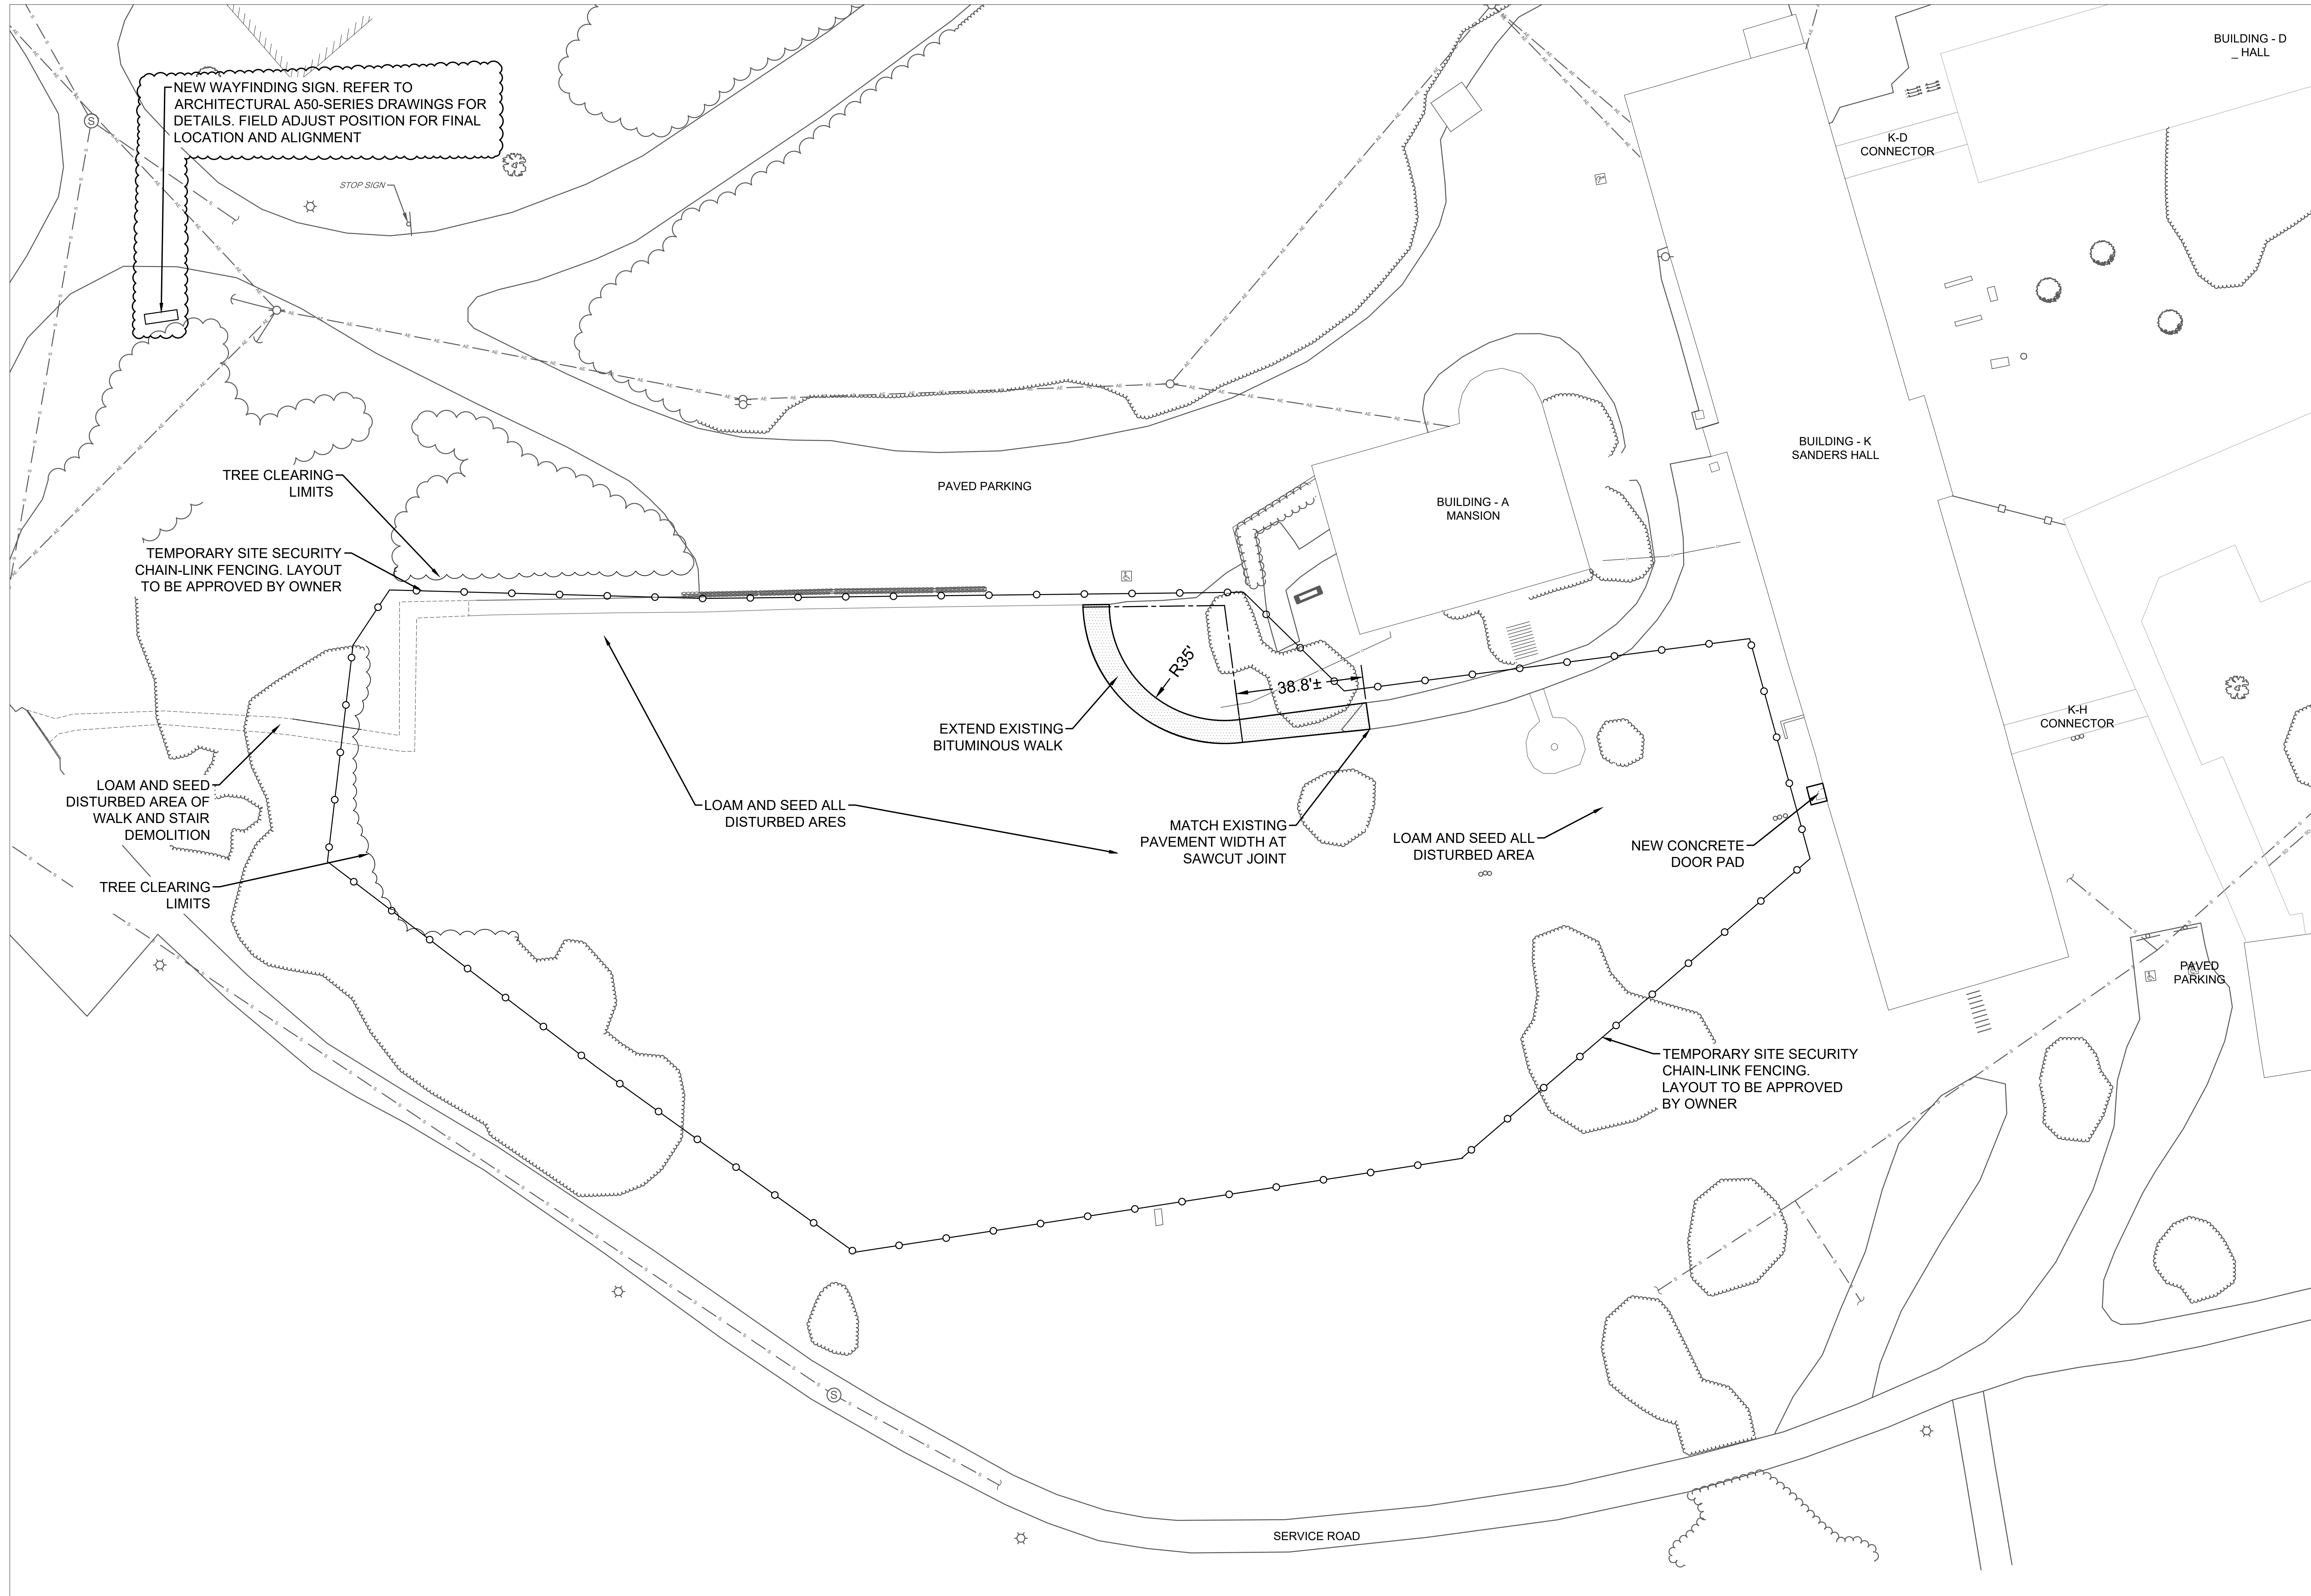


CONSTRUCTION DOCUMENTS

JULY 30, 2024

Revision Date	Revision Description
08-23-2024	ADDENDUM 1

Drawn by: FLC / TNE

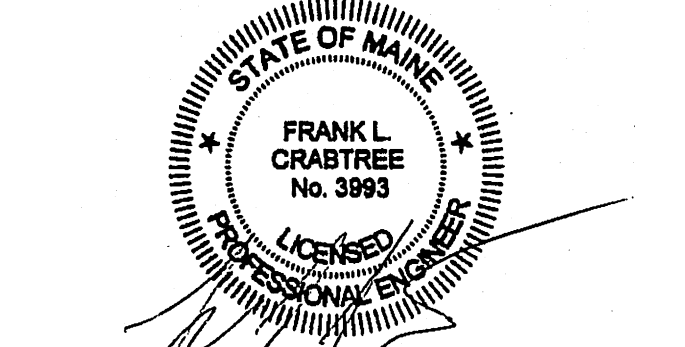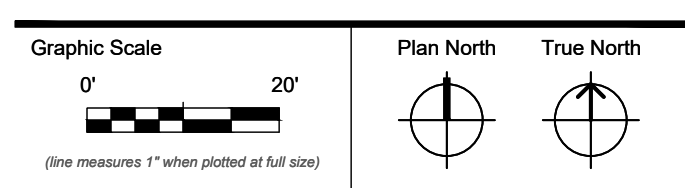

CONSTRUCTION DOCUMENTS

JULY 30, 2024



Revision Date	Revision Description
08-23-2024	ADDENDUM 1

Drawn by: FLC / TNE

SITE GRADING AND
EROSION CONTROL PLAN

PHASE 1 - GENERAL SCOPE NOTES

1. SEE CIVIL DRAWINGS FOR FULL SITE DEMOLITION, FILL AND REGRADING DETAILS.
2. SEE ELECTRICAL AND PLUMBING DRAWINGS FOR UTILITY DEMOLITION AND REROUTING SCOPE.
3. SEE STRUCTURAL DRAWINGS FOR NEW GATEWAY FOUNDATION DETAILS. SCHOOL WILL REMAIN ACTIVE DURING CONSTRUCTION. CONTRACTOR TO PROVIDE OWNER WITH WEEKLY UPDATES AND ANTICIPATED DISRUPTION SCHEDULES. COORDINATE WITH OWNER TO ENSURE SAFE WORK AREAS AND TRAVEL PATHS.
- 4.

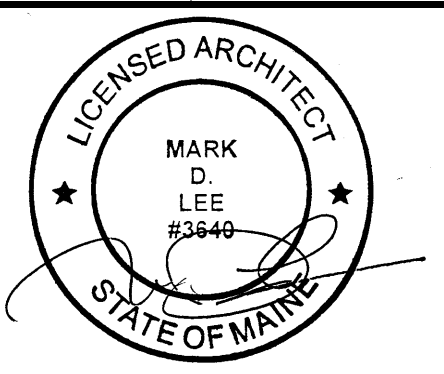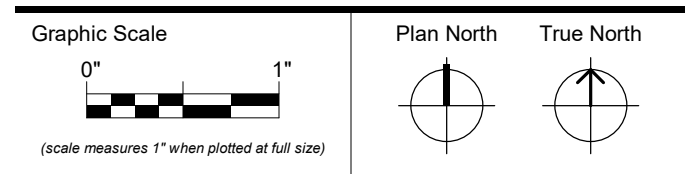

CONSTRUCTION DOCUMENTS

JULY 30, 2024

Revision Date	Revision Description
08-23-2024	ADDENDUM 1

Drawn by: KLS

GENERAL DEMOLITION NOTES

- ALL WORK TO BE DONE IN COMPLIANCE WITH LOCAL, STATE, AND FEDERAL REGULATIONS, CODES AND STANDARDS, AND MEET THE REQUIREMENTS OF THE AUTHORITIES HAVING JURISDICTION.
- BUILDINGS 'B', 'G', AND THE CONNECTORS TO BE DEMOLISHED IN THEIR ENTIRETY. REMOVALS TO INCLUDE ALL FOUNDATIONS, FOOTINGS AND ASSOCIATED CONSTRUCTED SUB GRADE ELEMENTS.
- SEE SPECIFICATIONS BACKFILLING SCOPE REQUIREMENTS.
- DRAWINGS ARE ILLUSTRATIVE OF APPROXIMATE EXISTING CONDITIONS. CONDITIONS HAVE NOT BEEN FIELD VERIFIED. IT IS THE CONTRACTOR'S RESPONSIBILITY TO FIELD VERIFY ALL CONDITIONS.
- REMEDICATION OF HAZARDOUS MATERIALS TO BE COMPLETED PRIOR TO DEMOLITION EXCEPT AS NOTED BELOW.
 - ROOFING: SEE HAZARDOUS MATERIALS REPORT
 - ANY HAZARDOUS MATERIALS DISCOVERED DURING DEMOLITION PROCESS SHOULD FOLLOW APPROVED ABATEMENT PROCEDURES AND APPLICABLE LAWS.
- ALL BUILDING PLUMBING UTILITIES TO BE DISCONNECTED AND CAPPED AT THE SHUT OFF VALVES PRIOR TO START OF DEMOLITION.
- TEMPORARY SINGLE POINT POWER AND WATER CONNECTIONS PROVIDED BY OWNER. SEE LOCATION NOTED ON INDEX PLAN. CONTRACTOR RESPONSIBLE FOR CODE COMPLIANT DISTRIBUTION BEYOND SINGLE POINT PROVIDED.
- BUILDING UTILITIES LOCATED WITHIN THE PROJECT SCOPE AREA THAT SERVE OTHER BUILDINGS TO BE MAINTAINED. ANY DISRUPTION CAUSED BY THE SCOPE OF WORK IS TO BE COORDINATED WITH OWNER AND UTILITY PROVIDER PRIOR TO ASSOCIATED WORK.
- ANY ASSOCIATED UTILITIES SERVING BUILDINGS 'B' AND 'C' FROM DISTRIBUTION THAT ALSO CONNECTS TO OTHER BUILDING IS TO BE DISCONNECTED WITH NO DISRUPTION OF SERVICE TO OTHER BUILDINGS. DISCONNECT WORK TO BE COORDINATED WITH OWNER AND UTILITY PROVIDER PRIOR TO ASSOCIATED WORK.





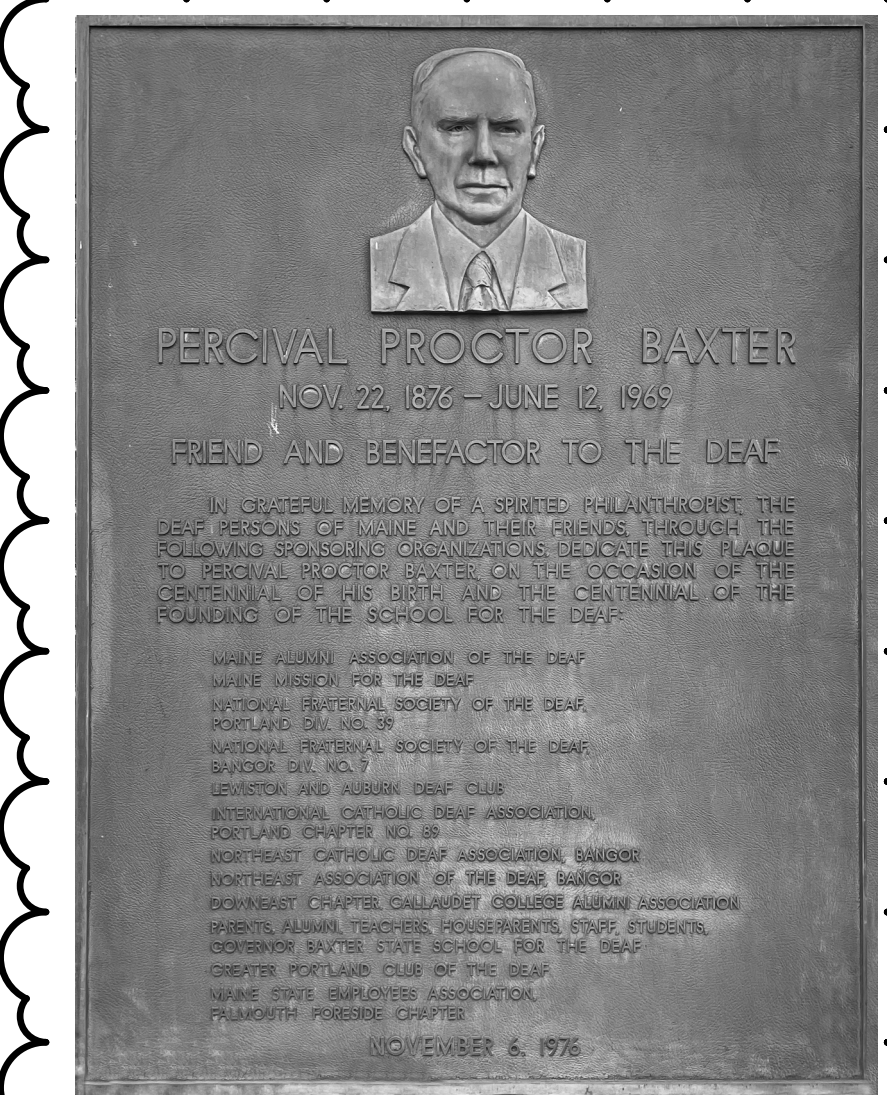


FIG. 1

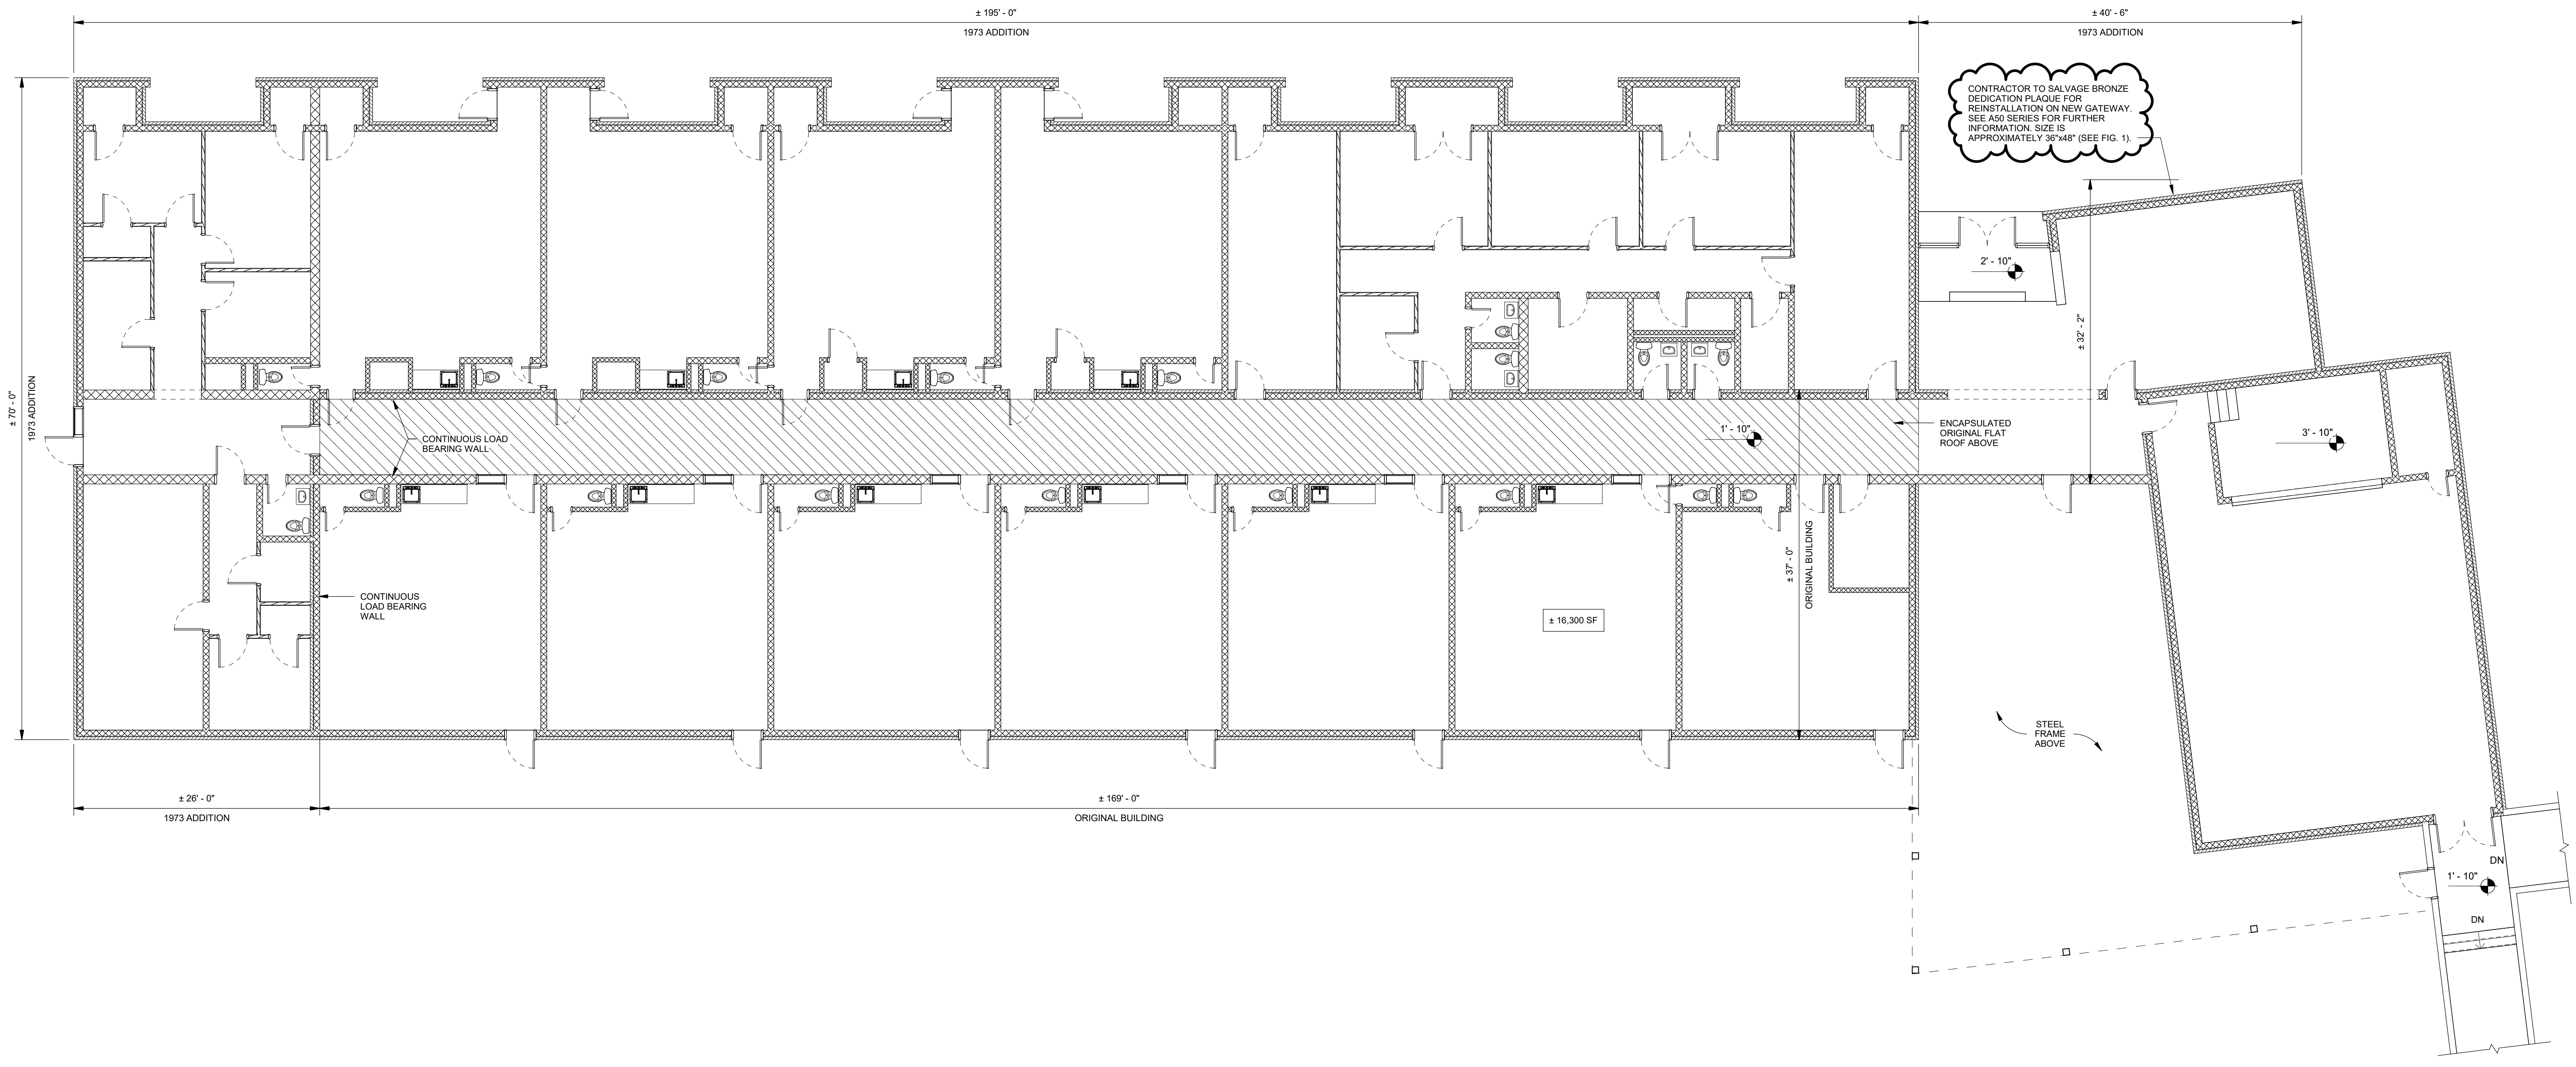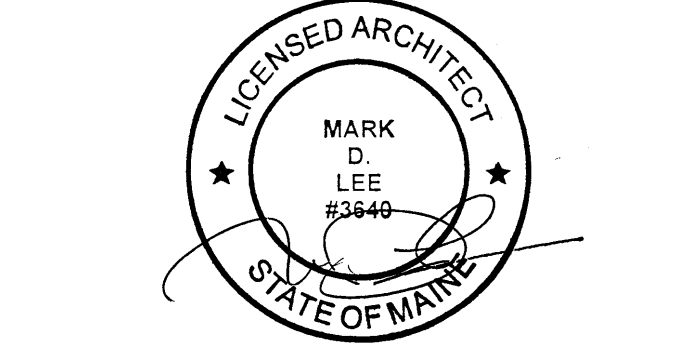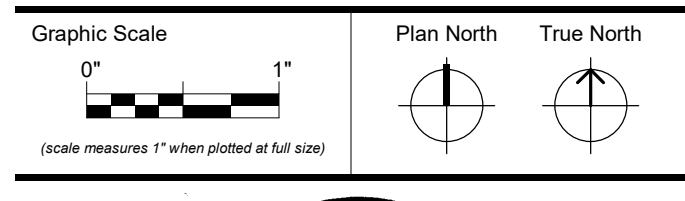

KEY PLAN

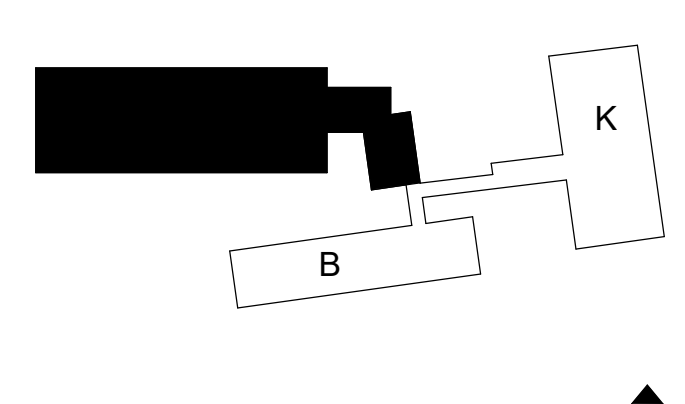

CONSTRUCTION DOCUMENTS

JULY 30, 2024

Revision Date	Revision Description
08-23-2024	ADDENDUM 1

Drawn by: KLS

DEMOLITION PLAN - BUILDING G