

**ADDENDUM NO. 2**

To Contract Documents for:

**2024 CEMETERY EXPANSION  
SOUTHERN MAINE VETERANS' CEMETERY  
SPRINGVALE, MAINE**

Owner:

State of Maine  
Department of Defense, Veterans and Emergency Management  
Bureau of Maine Veterans' Services

Project Designer and Engineer:  
Walsh Engineering Associates, Inc.  
One Karen Drive, Suite 2A  
Westbrook, ME 04092

Date: August 19, 2024

**This Addendum modifies, amends and supplements designated parts of the Contract Documents, Project Manual and Drawings dated July 12, 2024 and is hereby made a part thereof by reference and shall be as binding as though inserted in its entirety in the locations specified herein. It shall be the responsibility of the Contractor to notify all Subcontractors and Suppliers of any changes or modifications contained in this addendum.**

---

**Acknowledge receipt of this Addendum on the Bid Form. Failure to do so may result in disqualification of the Bid.**


---

**CHANGES TO THE CONTRACT DOCUMENTS**

Item No.	Section/Sheet No.	Description
1	00 43 13	Contractor Bid Bond may be attached to bid form as a PDF and emailed to BGS.
2	C5.3	Side slopes of Grassed Underdrain Soil Filter Detail 1 on C5.3 are to be 2:1.
3	Col-1	See revised Section A2 attached to this Addendum
4	Various	<b>Contractor Question:</b> Please clarify testing and inspection requirements and who is paying for it. <b>Answer:</b> The Contractor shall be responsible for testing adequate to show the Owner that construction and materials meet the requirements. The Owner will not be performing independent testing. Testing by the Contractor is anticipated to be primarily sieve and proctor tests for pavement aggregates,

limited compaction testing (one or two for sidewalks), and concrete testing for slump, air and one set of three concrete cylinders for each columbarium foundation.

END OF ADDENDUM #2

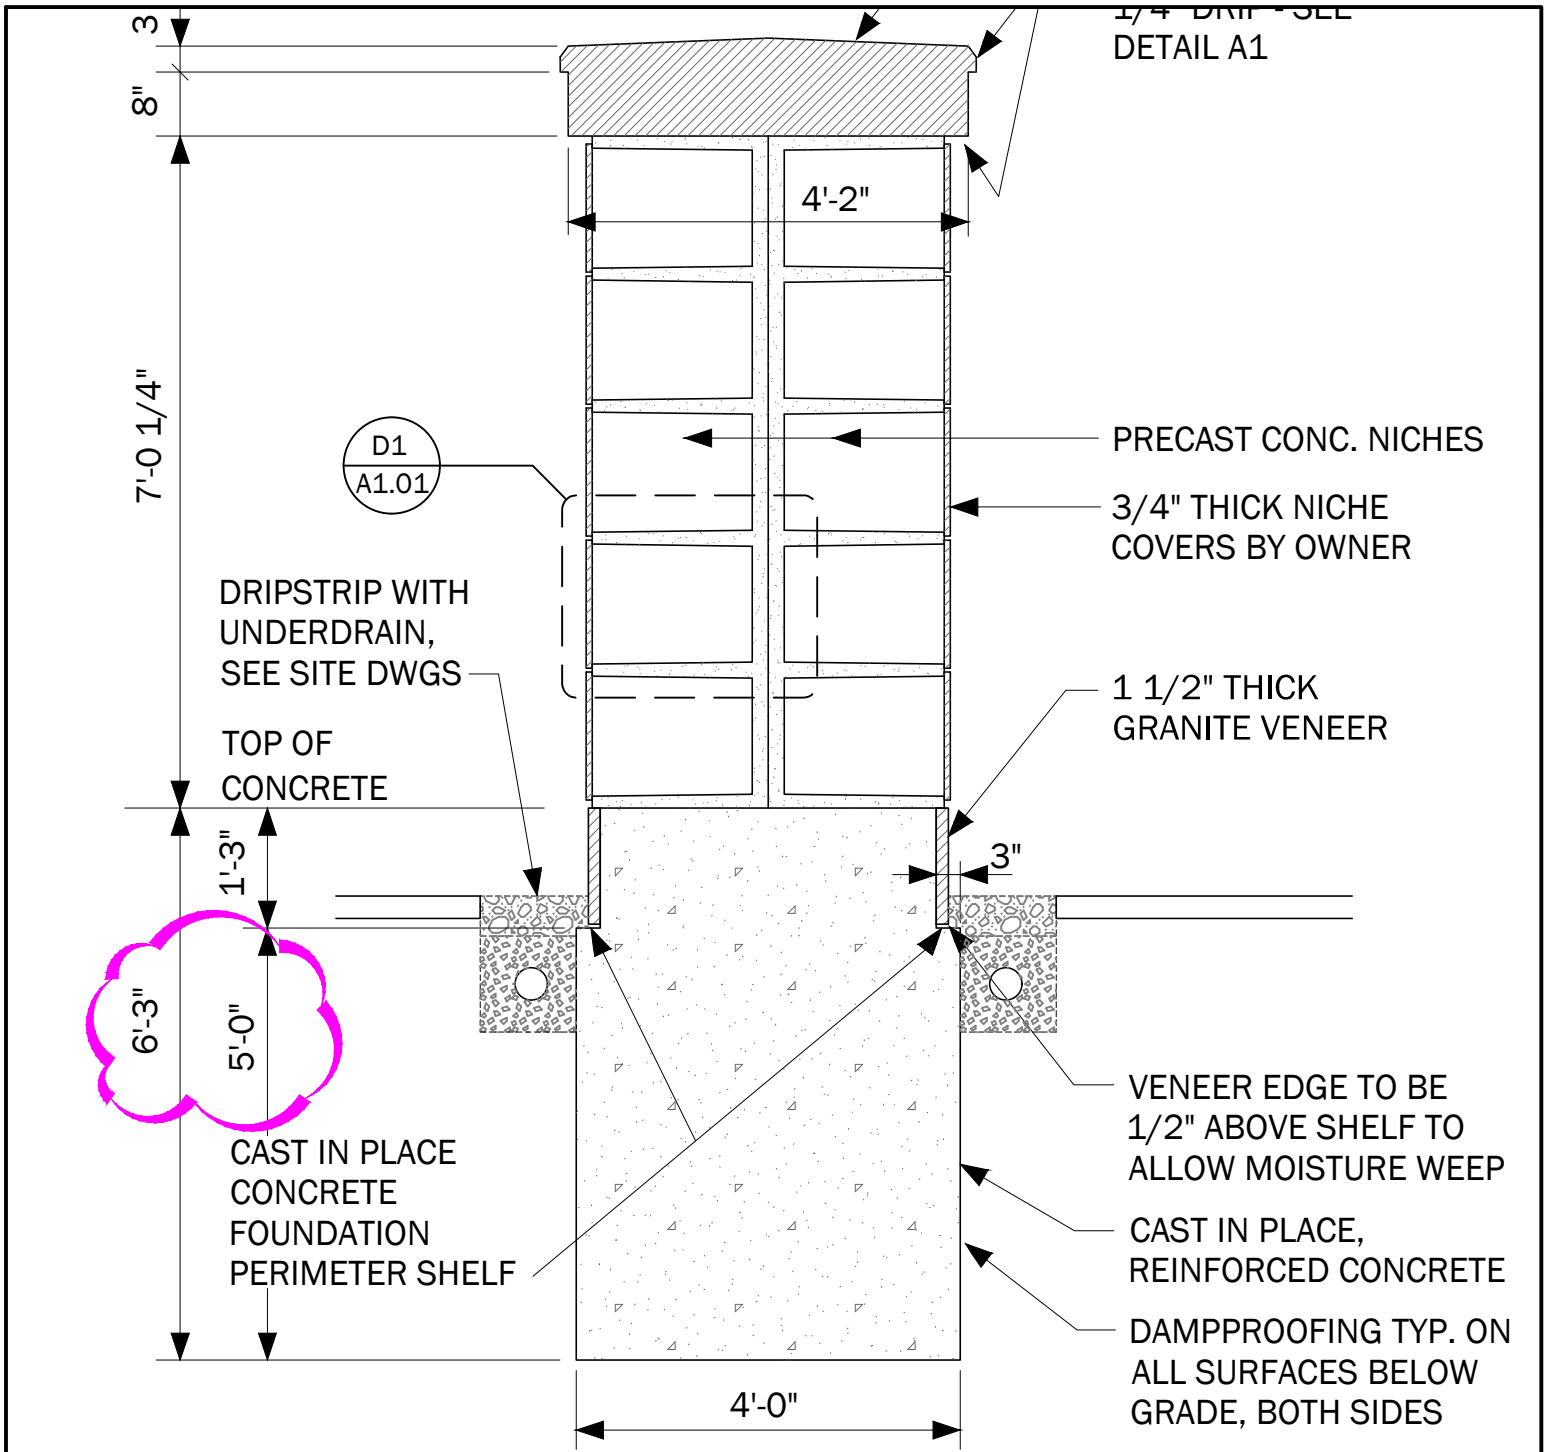

ADDENDUM #2  
 NCA PROJECT #FAI ME-23-24  
 BGS PROJECT #3743

# SECTION

SCALE: 1/2" = 1'-0"

REFERENCE DRAWING: Col-1

# A2

**WALSH**  
 ENGINEERING ASSOCIATES, INC.

One Karen Dr., Suite 2A | Westbrook, Maine 04092  
 ph: 207.553.9898 | www.walsh-eng.com

Copyright © 2024

## 2024 Cemetery Expansion

Southern Maine Veterans' Cemetery  
 83 Stanley Road  
 Springvale, Maine

Sheet Title:  
**LOCATION PLAN**

Job No.: 105.5  
 Date: AUGUST 16, 2024  
 Scale: AS SHOWN  
 Drawn: JDC/NGC  
 Checked: NGC